

OTTAWA COUNTY ENGINEERS OFFICE

REFERENCE NO. 12-7-15-H
SOUTH QUARTER POST SEC. 12
CARROLL TWP.
SHEET 1 OF 1.

ROUTE: T-224 RIDER RD.
@ T-223 COVER RD.

TOWNSHIP: CARROLL

SECTION: 12

T 7 NR 15 E.

NORTHING:

EASTING:


DATUM:

PERSONNEL:

M. WITTMAN, P.S.
J. ALLEN
J. HAYES - BEC

DATE / WEATHER / TEMP:

JULY 24, 2020
SUNNY
80° F

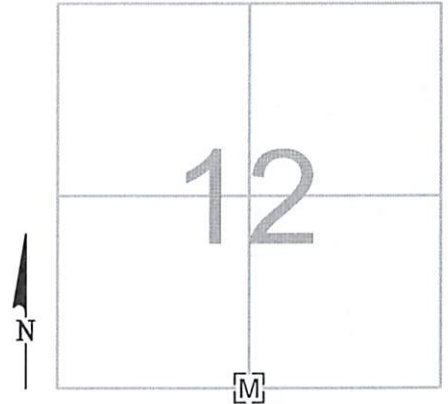

MONUMENT INFORMATION

MONUMENT TYPE: 1" SQ. IRON PIN IN MON BOX
ON SURFACE - BELOW: 1.58'
LEFT - CL PAV'T - RIGHT: 1.15' RIDER ROAD
LEFT - CL PAV'T - RIGHT: 22' COVER ROAD



MISC. INFORMATION

FD EXISTING DIG HOLE ON SURFACE THAT
MATCHED TIES IN STONE BOOK. SET A 5/8"
DIAMETER x 30" LONG REBAR "S" BENT FOR AN
OFFSET ON EAST SIDE OF EXISTING IRON PIN
TO BRING POINT UP TO A NEW BOX AT THE
SURFACE.

JULY24, 2020

SET 5/8" Ø IRON PIN OVER
1" SQUARE IRON PIN IN
MONUMENT BOX

