

OTTAWA COUNTY ENGINEERS OFFICE

REFERENCE NO. 13-7-15-A
NW CORNER POST SEC. 13
CARROLL TWP.
SHEET 1 OF 1.

ROUTE: C-104 TOUSSAINT SOUTH RD.

TOWNSHIP: CARROLL

SECTION: 13

T 7 NR 15 E.


NORTHING:

EASTING:

DATUM:

PERSONNEL:
M. WITTMAN, P.S.
J. ALLEN

DATE / WEATHER / TEMP:
MARCH 19, 2012
SUNNY
75° F

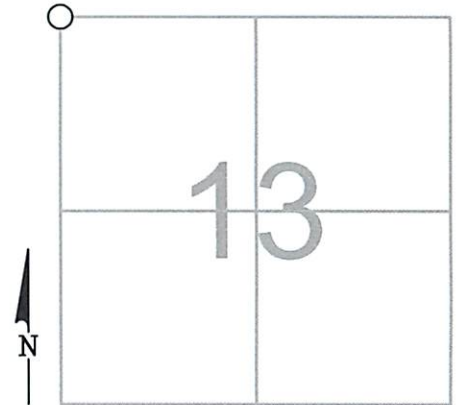

MONUMENT INFORMATION

MONUMENT TYPE: FD. 1" SQ. IRON PIN W/ DH
ON SURFACE - BELOW: 0.39'
LEFT - CL PAV'T - RIGHT: 1.35'



MISC. INFORMATION

MARCH 19, 2012

SET MONUMENT BOX OVER
1" SQUARE IRON PIN

