

# OTTAWA COUNTY ENGINEERS OFFICE

REFERENCE NO. 13-7-15-B  
NORTH QUARTER POST SEC. 13  
CARROLL TWP.  
SHEET 1 OF 1.

ROUTE: T-224 RIDER RD.  
@ T-223 COVER RD.

TOWNSHIP: CARROLL

SECTION: 13

T 7 NR 15 E.

NORTHING:

EASTING:


DATUM:

**PERSONNEL:**

M. WITTMAN, P.S.  
J. ALLEN  
J. HAYES - BEC

**DATE / WEATHER / TEMP:**

JULY 24, 2020  
SUNNY  
80° F

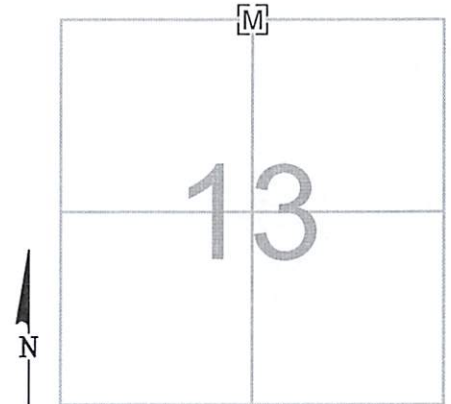

MONUMENT INFORMATION

MONUMENT TYPE: 1" SQ. IRON PIN IN MON BOX  
ON SURFACE - BELOW: 1.58'  
LEFT - CL PAV'T - RIGHT: 1.15' RIDER ROAD  
LEFT - CL PAV'T - RIGHT: 22' COVER ROAD



MISC. INFORMATION

FD EXISTING DIG HOLE ON SURFACE THAT  
MATCHED TIES IN STONE BOOK. SET A 5/8"  
DIAMETER x 30" LONG REBAR "S" BENT FOR AN  
OFFSET ON EAST SIDE OF EXISTING IRON PIN  
TO BRING POINT UP TO A NEW BOX AT THE  
SURFACE.

JULY24, 2020

SET 5/8" Ø IRON PIN OVER  
1" SQUARE IRON PIN IN  
MONUMENT BOX

