

# OTTAWA COUNTY ENGINEERS OFFICE

REFERENCE NO. 13-7-15-D  
WEST QUARTER POST SEC. 13  
CARROLL TWP.  
SHEET 1 OF 1.

ROUTE: C-93 TOUSSAINT EAST RD.  
@ C-104 TOUSSAINT SOUTH RD.

TOWNSHIP: CARROLL

SECTION: 13

T 7 NR 15 E.


NORTHING:

EASTING:

DATUM:

PERSONNEL:  
M. WITTMAN, P.S.  
J. ALLEN

DATE / WEATHER / TEMP:  
OCTOBER 14, 2010  
SUNNY - W-NW  
63° F

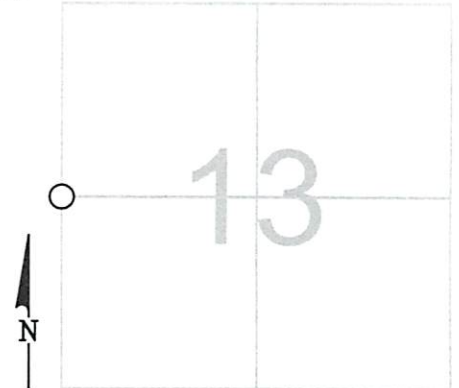

## MONUMENT INFORMATION

MONUMENT TYPE: FD. 1-1/4" SQ. IRON PIN  
ON SURFACE - BELOW: 0.45'  
LEFT - CL PAVT - RIGHT:  
  
SET DRILL HOLE IN CENTER OF PIN.



## MISC. INFORMATION

FD. RR SPK 0.13' BELOW SURFACE, TIED WITH  
X-TIES AND DUG FOR STONE. FD. IRON PIN PER  
COUNTY RECORDS 0.45' BELOW SURFACE. RR SPK  
WAS 0.06' WEST OF CENTER OF PIN.

OCTOBER 14, 2010

SET MONUMENT BOX OVER  
FOUND IRON PIN

