

OTTAWA COUNTY ENGINEERS OFFICE

REFERENCE NO. 13-7-15-E
CENTER POST SEC. 13
CARROLL TWP.
SHEET 1 OF 1.

ROUTE: T-224 RIDER RD.

TOWNSHIP: CARROLL

SECTION: 13

T 7 NR 15 E.

PERSONNEL:

M. WITTMAN, P.S.
J. ALLEN


NORTHING:

EASTING:

DATUM:

DATE / WEATHER / TEMP:

OCTOBER 14, 2010
SUNNY - W-NW
57° F

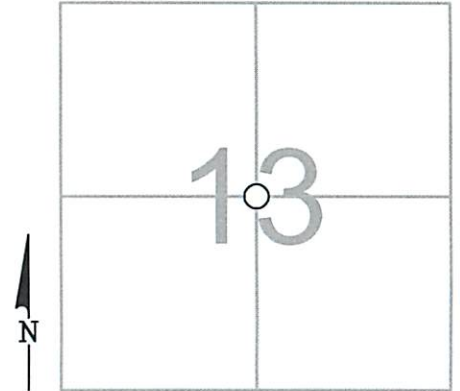

MONUMENT INFORMATION

MONUMENT TYPE: FD. IRON PIN WITH DRILL HOLE
ON SURFACE - BELOW: 1.53'
LEFT - CL PAV'T - RIGHT: 23.20'

1" X 2-3/4" IRON PIN



MISC. INFORMATION

PRODDED NEXT TO IRON PIN AND HIT SOLID
BELOW. COUNTY RECORDS STATE PIN IS OVER
STONE. ACCEPTED IRON PIN. FILLED HOLE WITH
BERM STONE FOR EASIER LOCATION OF PIN.

SET AN ORANGE DELINEATOR 1.00' EAST OF IRON
PIN.

