

# OTTAWA COUNTY ENGINEERS OFFICE

**REFERENCE NO.** 13-7-15-G  
 SW CORNER POST SEC. 13  
 CARROLL TWP.  
**SHEET** 1 OF 1.

**PERSONNEL:**  
 M. WITTMAN, P.S.  
 J. ALLEN  
 V. SZABO

**DATE / WEATHER / TEMP:**  
 MAY 10, 2017  
 SUNNY - E  
 61° F

**ROUTE:** C-104 TOUSSAINT SOUTH RD.  
 @ T-95 FICK RD.

**TOWNSHIP:** CARROLL


**SECTION:** 13

**T** 7 **NR** 15 **E.**

**NORTHING:**


**EASTING:**

**DATUM:**

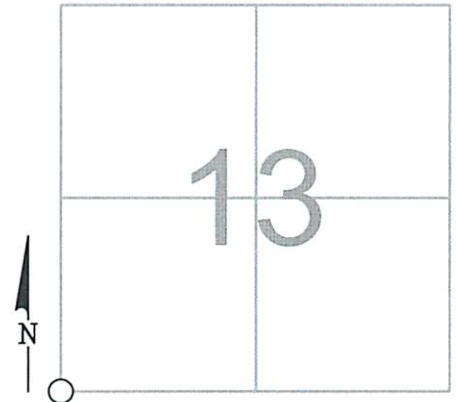

### MONUMENT INFORMATION

MONUMENT TYPE: FD. 5/8" Ø IRON PIN  
 ON SURFACE - BELOW: 0.73'  
 LEFT - CL PAV'T - RIGHT: 0.65' TOUSSAINT SOUTH ROAD  
 LEFT - CL PAV'T - RIGHT: 0.75' GENZMAN ROAD  
 IRON PIN OF RECORD IN STONE BOOK.

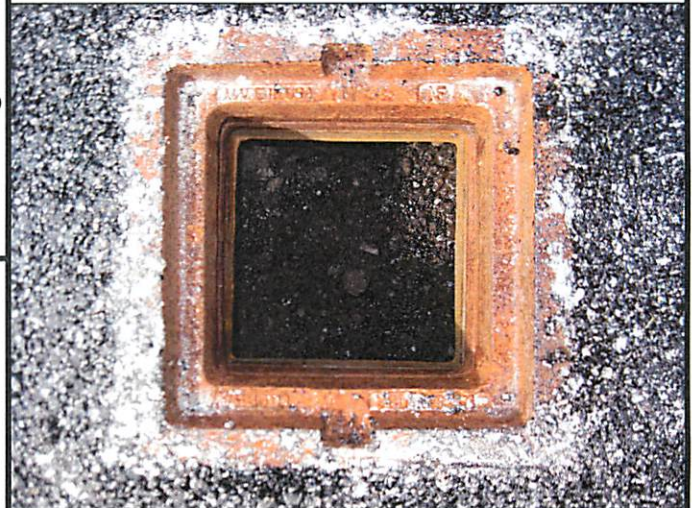

### MISC. INFORMATION

FD. MAG SPIKE ON SURFACE W/ 3'-0" PK NAIL  
 TIES N,S,E,W. TIED W/ X-TIES AND DUG FOR PIN  
 OF RECORD.  
 MAG SPIKE WAS ONLINE EAST AND WEST AND  
 0.02' SOUTH OF IRON PIN FOUND.

MAY 10, 2017

SET MONUMENT BOX OVER  
 5/8" Ø IRON PIN FOUND

