

# OTTAWA COUNTY ENGINEERS OFFICE

REFERENCE NO. 14-7-15-C  
NE CORNER POST SEC. 14  
CARROLL TWP.  
SHEET 1 OF 1.

ROUTE: C-104 TOUSSAINT SOUTH RD.

TOWNSHIP: CARROLL

SECTION: 14

T 7 NR 15 E.


NORTHING:

EASTING:

DATUM:

PERSONNEL:  
M. WITTMAN, P.S.  
J. ALLEN

DATE / WEATHER / TEMP:  
MARCH 19, 2012  
SUNNY  
75° F

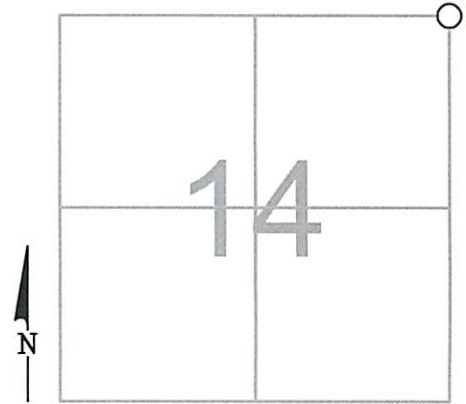

## MONUMENT INFORMATION

MONUMENT TYPE: FD. 1" SQ. IRON PIN W/ DH  
ON SURFACE - BELOW: 0.39'  
LEFT - CL PAV'T - RIGHT: 1.35'



## MISC. INFORMATION

MARCH 19, 2012

SET MONUMENT BOX OVER  
1" SQUARE IRON PIN

