

OTTAWA COUNTY ENGINEERS OFFICE

REFERENCE NO. 14-7-15-E
CENTER POST SECTION 14
CARROLL TWP.
SHEET 1 OF 1.

ROUTE: C-93 TOUSSAINT - EAST RD.

TOWNSHIP: CARROLL

SECTION: 14


T 7 NR 15 E.

PERSONNEL:
M. WITTMAN, P.S.
J. ALLEN

NORTHING:

EASTING:

DATUM:

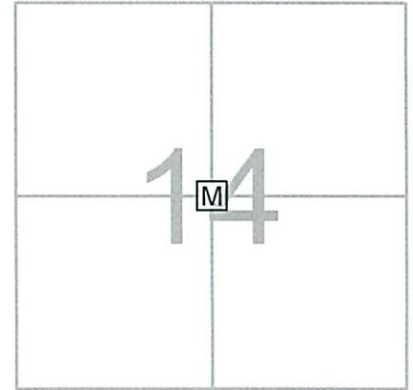

DATE / WEATHER / TEMP:
MARCH 19, 2012
SUNNY
70° F

MONUMENT INFORMATION

MONUMENT TYPE: SET 1" SQ. IRON PIN IN MON. BOX
ON SURFACE - BELOW:
LEFT - CL PAV'T - RIGHT: 8.80'



MISC. INFORMATION

IN WHITE LINE - SOUTH EDGE OF PAVEMENT

POINT WAS CALCULATED PER DECEMBER 1880
SURVEY MADE BY E. FRANK SB 2 PG 389

MARCH 19, 2012

SET 1" SQUARE IRON PIN
IN MONUMENT BOX

