

OTTAWA COUNTY ENGINEERS OFFICE


REFERENCE NO. 14-7-15-H
SOUTH QUARTER POST SEC. 14
CARROLL TWP.
SHEET 1 OF 1.

ROUTE: T-95 FICK RD.
TOWNSHIP: CARROLL
SECTION: 14
T 7 NR 15 E.

PERSONNEL:
M. WITTMAN, P.S.
J. ALLEN

NORTHING:
EASTING:
DATUM:

DATE / WEATHER / TEMP:
APRIL 4, 2012
SUNNY
53° F

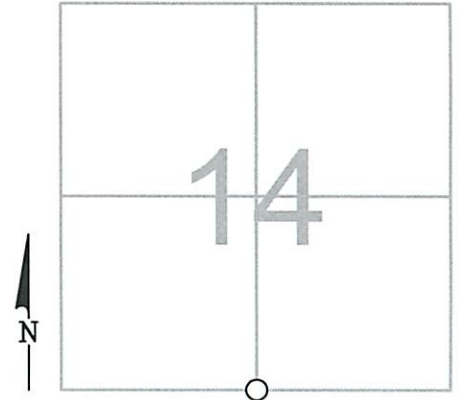

MONUMENT INFORMATION

MONUMENT TYPE: FD RAILROAD SPIKE
ON SURFACE - BELOW:
LEFT - CL PAV'T - RIGHT: 0.60'



MISC. INFORMATION

REPLACED RAILROAD SPIKE WITH 1" SQ. IRON PIN
IN MONUMENT BOX

APRIL 4, 2012

SET 1" SQUARE IRON PIN
IN MONUMENT BOX

