

OTTAWA COUNTY ENGINEERS OFFICE

REFERENCE NO. 15-7-15-E
CENTER POST SECTION 15
CARROLL TWP.
SHEET 1 OF 1.

ROUTE: C-93 TOUSSAINT - EAST RD.

TOWNSHIP: CARROLL

SECTION: 15

T 7 NR 15 E.


PERSONNEL:
M. WITTMAN, P.S.
J. ALLEN

NORTHING:

EASTING:

DATE / WEATHER / TEMP:
MARCH 19, 2012
SUNNY
65° F

DATUM:

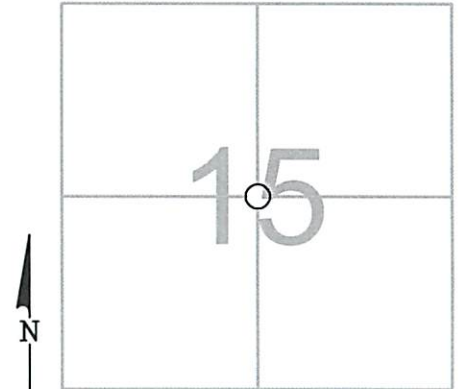

MONUMENT INFORMATION

MONUMENT TYPE: FD 1" SQ. IRON PIN
ON SURFACE - BELOW:
LEFT - CL PAV'T - RIGHT: 4.30'



MISC. INFORMATION

MARCH 19, 2012

SET MONUMENT BOX OVER
1" SQUARE IRON PIN

