OTTAWA COUNTY ENGINEERS OFFICE

REFERENCE NO. 15-7-15-G SOUTHWEST CORNER SEC. 15

CARROLL TWP.
SHEET 1 OF 1.

M. WITTMAN, P.S.

C. MILLER, E. KOCH

PERSONNEL:

J. ALLEN

T-95 FICK RD.

ROUTE: T-102 BEHLMAN RD. @

TOWNSHIP: CARROLL

SECTION: 15

T 7 NR 15 E.

NORTHING:


EASTING:

DATE / WEATHER / TEMP:

J. HAYES, D. TORIS, JR. - BEC

JUNE 25, 2009 SUNNY NE 85° F

DATUM:

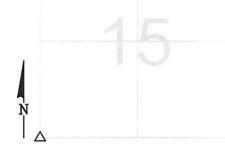

MONUMENT INFORMATION

MONUMENT TYPE: FD LIMESTONE W/ NOTCH

ON SURFACE - <u>BELOW</u>: 1.38' <u>LEFT</u> - CL PAV'T - RIGHT: 2.65' RECTANGULAR STONE: 12" x 6 1/2"

ALSO HAD 1 1/2" x 1 1/2" WOOD HUB IN WEST SIDE OF

STONE INLINE WITH E-W NOTCH.

USED CENTER OF NOTCH ON N/S CENTERLINE OF STONE.

MISC. INFORMATION

FD. MAG NAIL AND WASHER W/ CROSS TIES ON SURFACE. REMOVED NAIL AND WASHER AND DUG FOR STONE. FD. RAILROAD SPIKE 0.73' BELOW SURFACE. RR SPIKE WAS 0.05' EAST OF MAG NAIL AND WASHER. MAG NAIL AND WASHER WAS 0.33' NORTH OF NOTCH IN STONE,



