

OTTAWA COUNTY ENGINEERS OFFICE

REFERENCE NO. 15-7-15-I
SE CORNER POST SECTION 15
CARROLL TWP.
SHEET 1 OF 1.

ROUTE: T-101 LEUTZ RD.
@ T-95 FICK RD.

TOWNSHIP: CARROLL

SECTION: 15

T 7 N R 15 E.


NORTHING:

EASTING:

DATUM:

PERSONNEL:
M. WITTMAN, P.S.
J. ALLEN
C. MILLER


DATE / WEATHER / TEMP:
JUNE 5, 2009
SUNNY N
68° F

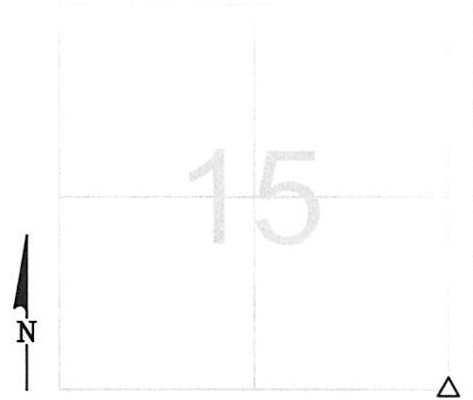

MONUMENT INFORMATION

MONUMENT TYPE: FD LIMESTONE W/ DRILL HOLE
ON SURFACE - BELOW: 1.55'
LEFT - CL PAV'T - RIGHT: 1.80'
RECTANGULAR STONE: 11" x 8"

USED DRILL HOLE

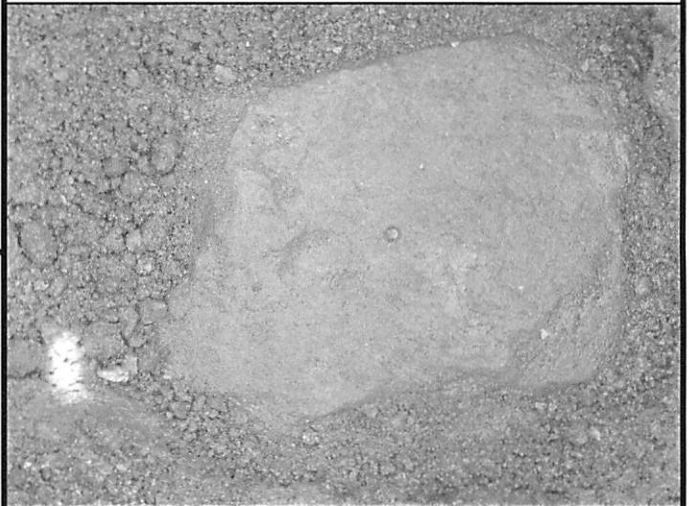

MISC. INFORMATION

BEC ASSOCIATES DUG STONE AND REPORTED
TO US ON 1-4-08.

JUNE 5, 2009

SET 1" SQUARE IRON PIN
IN MONUMENT BOX OVER
STONE

