

OTTAWA COUNTY ENGINEERS OFFICE

REFERENCE NO. 17-7-15-D
 WEST QUARTER POST SEC. 17
 CARROLL TWP.
 SHEET 1 OF 1.

ROUTE: C-23 BENTON-CARROLL RD.
 TOWNSHIP: CARROLL
 SECTION: 17
 T 7 NR 15 E.

PERSONNEL:
 M. WITTMAN, P.S.
 M. SANDRETTO

NORTHING:
 EASTING:
 DATUM:



DATE / WEATHER / TEMP:
 MARCH 8, 2006
 OVERCAST S
 41° F

MONUMENT INFORMATION

MONUMENT TYPE: FD STONE IN MON. BOX
 ON SURFACE - BELOW: 1'- 3 $\frac{1}{4}$ "
 LEFT - CL PAV'T - RIGHT:
 STONE: 5" x 4"
 USED HIGH POINT OF STONE.




MISC. INFORMATION

STONE WAS REMOVED DURING RECONSTRUCTION
 OF TOUSSAINT EAST ROAD IN 2008.

1" SQ. IRON PIN IN MONUMENT BOX SET
 SEPTEMBER 2, 2008 - M. WITTMAN, P.S., J. ALLEN,
 S. ULLRICH, M. ULLRICH

LONG TIES ARE TO MAG NAILS
 IN FACE OF POLES

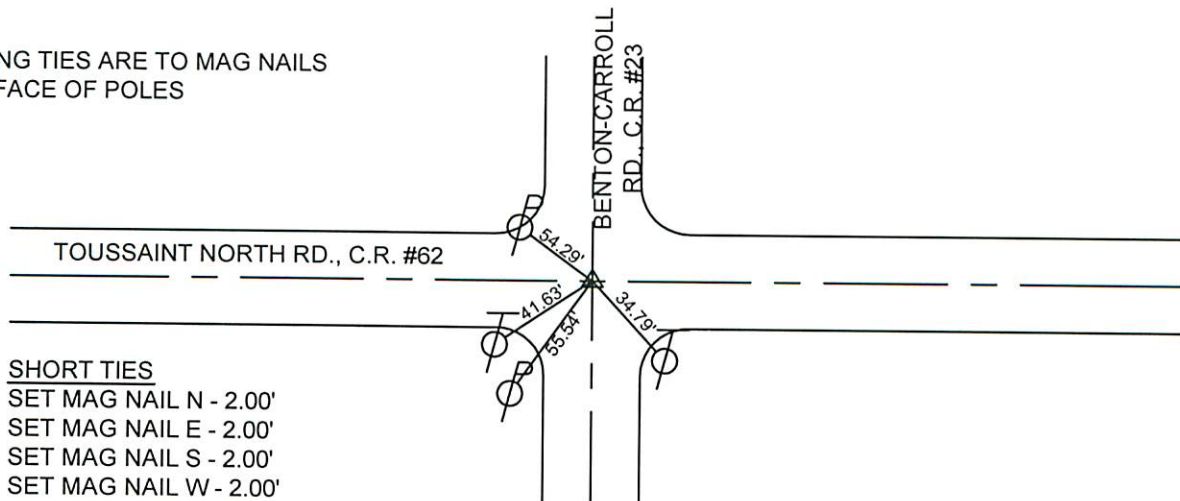

SHORT TIES
 SET MAG NAIL N - 2.00'
 SET MAG NAIL E - 2.00'
 SET MAG NAIL S - 2.00'
 SET MAG NAIL W - 2.00'