

OTTAWA COUNTY ENGINEERS OFFICE

REFERENCE NO. 17-7-15-E
CENTER POST SECTION 17
CARROLL TWP.
SHEET 1 OF 1.

ROUTE: C-93 TOUSSAINT EAST RD.

TOWNSHIP: CARROLL

SECTION: 17

T 7 NR 15 E.

PERSONNEL:
M. WITTMAN, P.S.
M. SANDRETTO


NORTHING:

EASTING:

DATUM:

DATE / WEATHER / TEMP:

MARCH 8, 2006
OVERCAST S
45° F

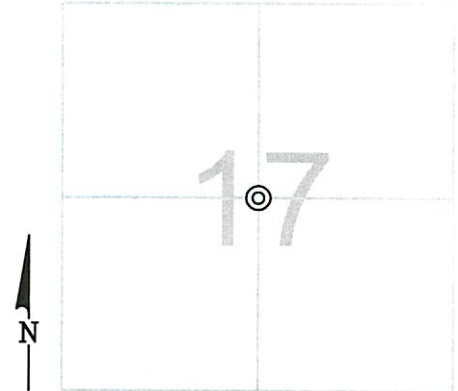

MONUMENT INFORMATION

MONUMENT TYPE: SET 1" SQ IRON PIN IN MON BOX
ON SURFACE - BELOW:
LEFT - CL PAV'T - RIGHT: 0.5'

IRON PIPE SET OVER STONE PER D.J. NISSEN
SURVEY DATED: MAY 16, 1969



MISC. INFORMATION

3-8-2006: FOUND 5/8" IRON PIPE IN MON. BOX. PIPE SET OVER STONE PER D.J. NISSEN
SURVEY DATED: 5-16-1969. PRODDED 11 3/8" DOWN ALONGSIDE PIPE TO REFUSAL IN 3
SPOTS IN MON. BOX. PLACE 3 SQ. RISERS AND LID OVER BOX TO ALLOW FOR
ACCESS. NEED TO DIG FURTHER AND LOCATE STONE. STONE NEVER LOCATED.

PIPE AND BOX WERE REMOVED DURING RECONSTRUCTION OF
TOUSSAINT EAST ROAD IN 2008.

1" SQUARE IRON PIN IN MONUMENT BOX SET SEPTEMBER 2, 2008
M. WITTMAN, P.S., J. ALLEN, S. ULLRICH, M. ULLRICH

