

OTTAWA COUNTY ENGINEERS OFFICE

REFERENCE NO. 18-7-15-E
CENTER POST SECTION 18
CARROLL TWP.
SHEET 1 OF 1.

PERSONNEL:
M. WITTMAN, P.S.
M. SANDRETTO

DATE / WEATHER / TEMP:
MARCH 7, 2006
SUNNY
39° F

ROUTE: C-93 TOUSSAINT EAST RD.

TOWNSHIP: CARROLL

SECTION: 18

T 7 NR 15 E.

NORTHING:

EASTING:

DATUM:



MONUMENT INFORMATION


MONUMENT TYPE: FD STONE IN MON. BOX
ON SURFACE - BELOW: 1'- $\frac{1}{2}$ "
LEFT - CL PAV'T - RIGHT:



MISC. INFORMATION

STONE WAS REMOVED DURING RECONSTRUCTION
OF TOUSSAINT EAST ROAD IN 2008.

1" SQ. IRON PIN IN MONUMENT BOX SET
SEPTEMBER 2, 2008 - M. WITTMAN, P.S., J. ALLEN,
S. ULLRICH, M. ULLRICH

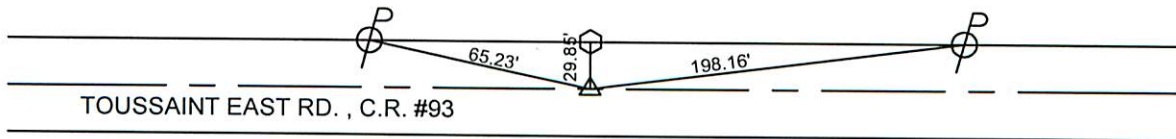

SHORT TIES

SET MAG NAIL N - 2.00'
SET MAG NAIL E - 2.00'
SET MAG NAIL S - 2.00'
SET MAG NAIL W - 2.25'