

# OTTAWA COUNTY ENGINEERS OFFICE

REFERENCE NO. 18-7-15-F  
EAST QUARTER POST SEC. 18  
CARROLL TWP.  
SHEET 1 OF 1.

ROUTE: C-23 BENTON-CARROLL RD.

TOWNSHIP: CARROLL

SECTION: 18

T 7 NR 15 E.

**PERSONNEL:**

M. WITTMAN, P.S.  
M. SANDRETTO


NORTHING:

EASTING:

DATUM:

**DATE / WEATHER / TEMP:**

MARCH 8, 2006  
OVERCAST S  
41° F

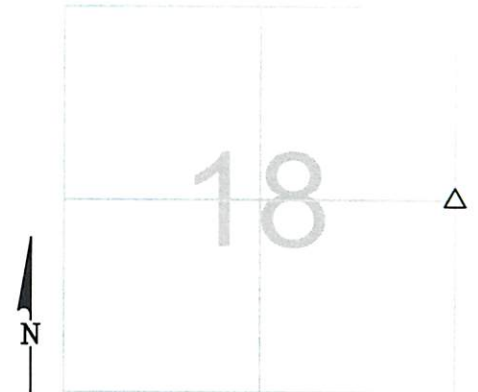

MONUMENT INFORMATION

MONUMENT TYPE: FD STONE IN MON. BOX  
ON SURFACE - BELOW: 1'- 3 $\frac{1}{4}$ "  
LEFT - CL PAV'T - RIGHT:  
STONE: 5" x 4"

USED HIGH POINT OF STONE.




MISC. INFORMATION

STONE WAS REMOVED DURING RECONSTRUCTION  
OF TOUSSAINT EAST ROAD IN 2008.

1" SQ. IRON PIN IN MONUMENT BOX SET  
SEPTEMBER 2, 2008 - M. WITTMAN, P.S., J. ALLEN,  
S. ULLRICH, M. ULLRICH

LONG TIES ARE TO MAG NAILS  
IN FACE OF POLES

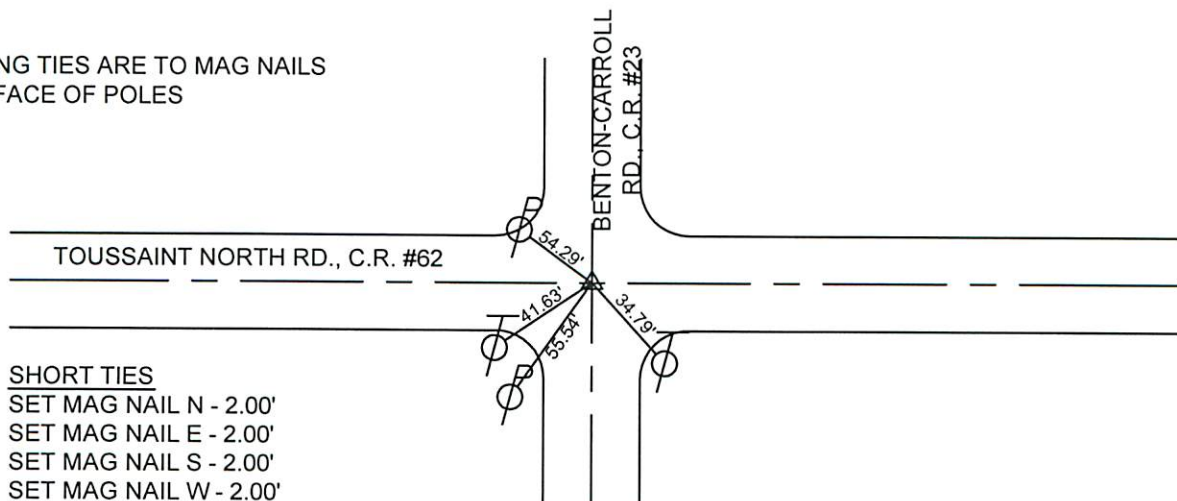

SHORT TIES

SET MAG NAIL N - 2.00'  
SET MAG NAIL E - 2.00'  
SET MAG NAIL S - 2.00'  
SET MAG NAIL W - 2.00'