

OTTAWA COUNTY ENGINEERS OFFICE

REFERENCE NO. 18-7-15-G
SW CORNER SECTION 18
CARROLL TWP.
SHEET 1 OF 1.

ROUTE: C-23 BENTON-CARROLL RD.
@ T-94 STRICKLE-TOUSSAINT RD.

TOWNSHIP: CARROLL

SECTION: 18

T 7 NR 15 E.


PERSONNEL:
M. WITTMAN, P.S.
M. ULLRICH

NORTHING:

EASTING:

DATUM:

DATE / WEATHER / TEMP:
SEPTEMBER 3, 2008
SUNNY HUMID
93° F

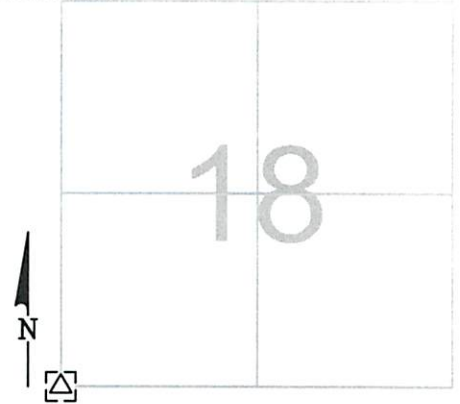

MONUMENT INFORMATION

MONUMENT TYPE: FD STONE W/ DRILL HOLE IN
MONUMENT BOX
ON SURFACE - BELOW:
LEFT - CL PAV'T - RIGHT: 10.5'



MISC. INFORMATION

STONE IS 0.75' W. OF W. E.O.P.

THIS IS A CLOSING CORNER

