

OTTAWA COUNTY ENGINEERS OFFICE

REFERENCE NO. 18-7-15-1
SE CORNER SECTION 18
CARROLL TWP.
SHEET 1 OF 1.

PERSONNEL:
M. WITTMAN, P.S.
M. ULLRICH

DATE / WEATHER / TEMP:
SEPTEMBER 3, 2008
SUNNY HUMID
93° F

ROUTE: T-92 TOUSSAINT PORTAGE RD.
@ T-94 STRICKLE TOUSSAINT RD.

TOWNSHIP: CARROLL


SECTION: 18

T 7 NR 15 E.

NORTHING:

EASTING:

DATUM:

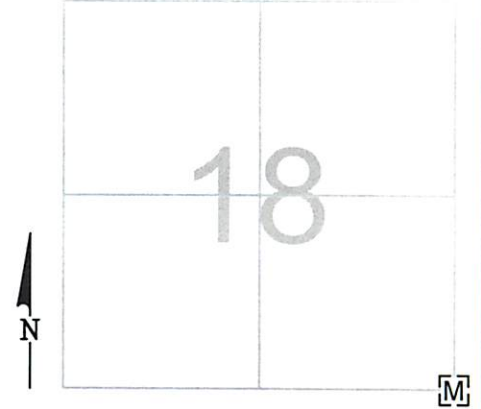

MONUMENT INFORMATION

MONUMENT TYPE: FD 1" SQ. IRON PIN IN
MONUMENT BOX
ON SURFACE - BELOW:
LEFT - CL PAV'T - RIGHT: 8.0'



MISC. INFORMATION

