

OTTAWA COUNTY ENGINEERS OFFICE

REFERENCE NO. 19-7-15-B
 NORTH QUARTER POST SEC. 19
 CARROLL TWP.
SHEET 1 OF 1.

ROUTE: T-94 STRICKLE-TOUSSAINT RD.

TOWNSHIP: CARROLL

SECTION: 19

T 7 **NR** 15 **E.**


PERSONNEL:
 M. WITTMAN, P.S.
 J. ALLEN

NORTHING:

EASTING:

DATE / WEATHER / TEMP:
 APRIL 4, 2013
 SUNNY - SE
 50° F

DATUM:

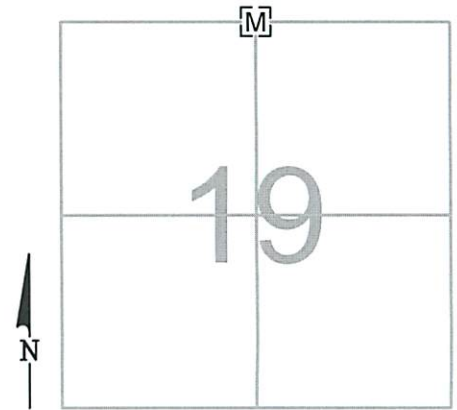

MONUMENT INFORMATION

MONUMENT TYPE: FD. 1/2" SQ IRON PIN IN MON BOX
 ON SURFACE - BELOW: 0.34'
 LEFT - CL PAV'T - RIGHT: 5.0'



MISC. INFORMATION

MARCH 4, 2013

PLACED RISERS TO BRING
 TO SURFACE

SET 5/8" IRON
 PIN w/ OCE CAP
 FOR REF. TIE
 1' ± FROM EOP

SET 5/8" IRON
 PIN w/ OCE CAP
 FOR REF. TIE
 1' ± FROM EOP

