

OTTAWA COUNTY ENGINEERS OFFICE

REFERENCE NO. 19-7-15-D
WEST QUARTER POST SEC. 19
CARROLL TWP.
SHEET 1 OF 1.

ROUTE: C-23 BENTON-CARROLL RD.

TOWNSHIP: CARROLL

SECTION: 19

T 7 NR 15 E.

PERSONNEL:

M. WITTMAN, P.S.
J. ALLEN
E. KOCH
C. MILLER

NORTHING:

EASTING:

DATE / WEATHER / TEMP:

JUNE 4, 2009
SUNNY E
60° F

DATUM:


M



19

MONUMENT INFORMATION

MONUMENT TYPE: SET 1" SQ. IRON PIN IN MON. BOX
ON SURFACE - BELOW:
LEFT - CL PAV'T - RIGHT: 8.40'

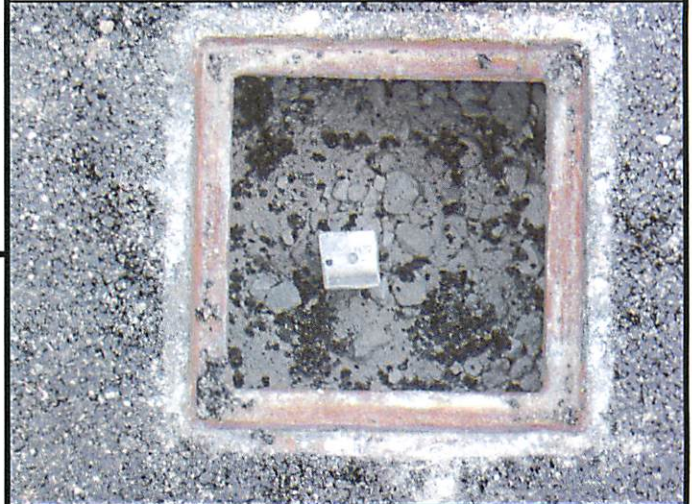

MISC. INFORMATION

6-4-09 - FD. RAILROAD SPIKE 0.21' BELOW SURFACE. TIED W/
CROSS TIES AND DUG FOR STONE. FD. 1 1/2" x 1 1/2" x 24" WOOD
HUB 0.31' BELOW SURFACE. WOOD HUB WAS 0.32' NORTH AND
0.27' EAST (AT BASE) FROM RAILROAD SPIKE. HUB HAD STRONG
LEAN TO THE WEST. CONTINUED TO DIG FOR STONE, STONE WAS
NOT FOUND.
6-30-09 - POINT ESTABLISHED AND SET BASED ON EVIDENCE
FOUND IN SURVEY MADE BY R.C. STEINMILLER DATED NOVEMBER
1972. RR SPIKE WAS 0.42' SOUTH AND 0.25' WEST OF NEW POINT.

THIS IS A CLOSING CORNER.

JUNE 30, 2009

SET 1" SQUARE IRON PIN
IN MONUMENT BOX

FD. 1" SQ. IP
IN MON. BOX
E 1/4 POST BENTON 24

