

OTTAWA COUNTY ENGINEERS OFFICE

REFERENCE NO. 2-7-15-D
WEST QUARTER POST SEC. 2
CARROLL TWP.
SHEET 1 OF 1.

PERSONNEL:
M. WITTMAN, P.S.
J. ALLEN

DATE / WEATHER / TEMP:
MAY 2, 2016
OVERCAST
47° F

ROUTE: C-24 DUFF-WASHA RD.
@ T-128 RUSSELL RD.

TOWNSHIP: CARROLL


SECTION: 2

T 7 NR 15 E.

NORTHING:

EASTING:

DATUM:

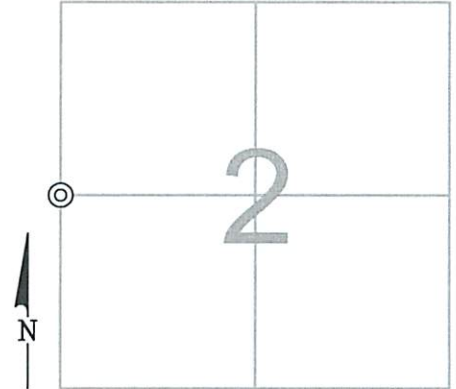

MONUMENT INFORMATION

MONUMENT TYPE: FD. RR SPIKE IN 1-1/4" Ø IRON PIPE
ON SURFACE - BELOW: 0.54'
LEFT - CL PAV'T - RIGHT: 0.70'

SET DRILL HOLE IN CENTER OF RR SPIKE.



MISC. INFORMATION

FD RR SPIKE 0.54' BELOW SURFACE, TIED W/ X-TIES
AND DUG FOR STONE OR IRON PIPE OF RECORD. FD
RR SPIKE WAS CRIMPED INSIDE OF A 1-1/4" Ø IRON
PIPE. IRON PIPE IS OF RECORD IN THE STONE BOOK.
ACCEPTED RR SPIKE IN IRON PIPE AS POINT AND SET
DRILL HOLE IN RR SPIKE.

MAY 2, 2016

SET MONUMENT BOX OVER
RR SPIKE IN IRON PIPE

