

OTTAWA COUNTY ENGINEERS OFFICE

REFERENCE NO. 20-7-15-D
WEST QUARTER POST SEC. 20
CARROLL TWP.
SHEET 1 OF 1.

ROUTE: T-92 TOUSSAINT - PORTAGE RD.
@ T-96 GENZMAN RD.

TOWNSHIP: CARROLL

SECTION: 20

T 7 N R 15 E.


NORTHING:

EASTING:

DATUM:

PERSONNEL:
M. WITTMAN, P.S.
J. ALLEN
E. KOCH
C. MILLER

DATE / WEATHER / TEMP:
MARCH 1, 2010
SUNNY - SW
64° F

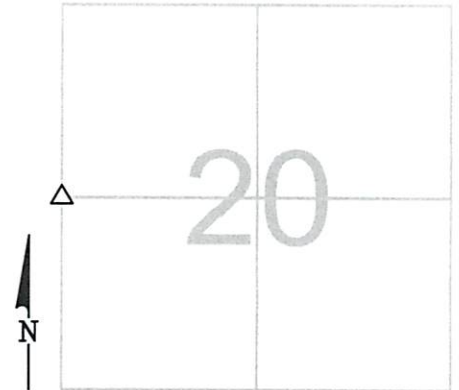

MONUMENT INFORMATION

MONUMENT TYPE: FD. 4"x8"x9" RECTANGULAR
LIMESTONE
ON SURFACE - BELOW: 2.52'
LEFT - CL PAV'T - RIGHT: 3.00'

USED CENTER OF STONE



MISC. INFORMATION

