

OTTAWA COUNTY ENGINEERS OFFICE

REFERENCE NO. 20-7-15-E
INTERIOR CORNER POST SEC. 20
CARROLL TWP.
SHEET 1 OF 1.

ROUTE: T-96 GENZMAN RD.

TOWNSHIP: CARROLL

SECTION: 20

T 7 NR 15 E.

PERSONNEL:

M. WITTMAN, P.S.
J. ALLEN
E. KOCH
C. MILLER


NORTHING:

EASTING:

DATE / WEATHER / TEMP:


MARCH 1, 2010
SUNNY - S
76° F

DATUM:

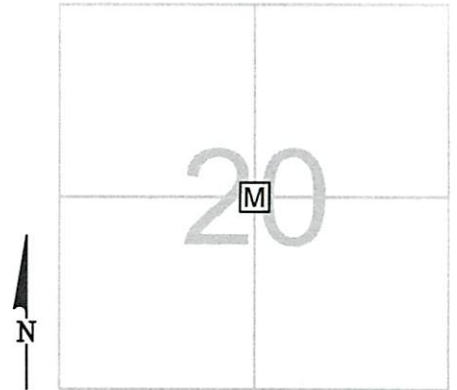

MONUMENT INFORMATION

MONUMENT TYPE: SET 1" SQ. IRON PIN IN
MONUMENT BOX
ON SURFACE - BELOW:
LEFT - CL PAV'T - RIGHT: 1.65'

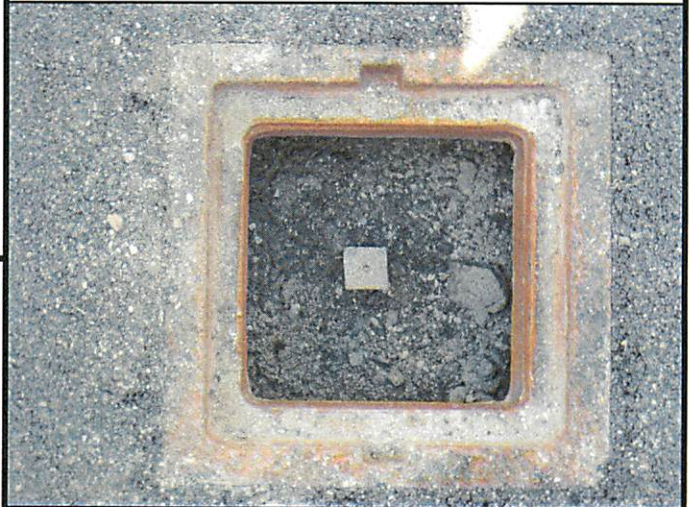

MISC. INFORMATION

FD. RR SPK 0.28' BELOW SURFACE PER COUNTY
RECORDS. TIED WITH X-TIES AND DUG FOR STONE.
DUG 1.5' TO CLAY AND PRODDED ANOTHER 3' AND
DID NOT FIND STONE. SET 1" SQUARE IRON PIN IN
PLACE OF RR SPK AS ACCEPTED BY NUMEROUS
PRIOR SURVEYS.

MARCH 1, 2010

SET 1" SQUARE IRON PIN
IN MONUMENT BOX

