

OTTAWA COUNTY ENGINEERS OFFICE

REFERENCE NO. 20-7-15-G
SW CORNER POST SEC 20
CARROLL TWP.

SHEET 1 OF 1.

PERSONNEL:
M. WITTMAN, P.S.
J. ALLEN

DATE / WEATHER / TEMP:
JUNE 21, 2011
SUNNY
81° F

ROUTE: T-92 TOUSSAINT PORTAGE RD.

TOWNSHIP: CARROLL


SECTION: 20

T 7 NR 15 E.

NORTHING:

EASTING:

DATUM:

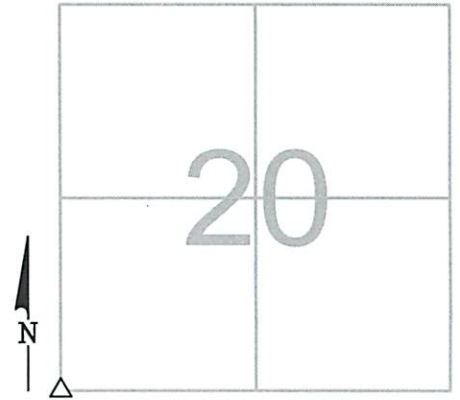

MONUMENT INFORMATION

MONUMENT TYPE: LIMESTONE W/ DH
ON SURFACE - BELOW: 1.82'
LEFT - CL PAV'T - RIGHT: 2.0'
RECTANGULAR STONE: 6"X7"X14"



MISC. INFORMATION

FD RR SPK W/ PUNCH MARK ON SURFACE
FIT TIES PER STONE RECORD
TIED RR SPK W/ X-TIES & DUG FOR STONE
RR SPK WAS 0.04' S OF DH ON LINE E&W

JUNE 21, 2011

SET 1" SQUARE IRON PIN
IN MONUMENT BOX OVER
STONE

