## OTTAWA COUNTY ENGINEERS OFFICE

REFERENCE NO. 21-7-15-D WEST QUARTER POST SEC. 21

CARROLL TWP.
SHEET 1 OF 1.

ROUTE: STATE ROUTE #19 @ T-96 GENZMAN RD.

TOWNSHIP: CARROLL

SECTION: 21

T 7 NR 15 E.

PERSONNEL:
M. WITTMAN, P.S.

J. ALLEN

S. HUSS - ODOT


M. CANTERBURY - ODOT

NORTHING:

**EASTING:** 

DATE / WEATHER / TEMP:

MARCH 28, 2010 SUNNY - SW 47° F DATUM:

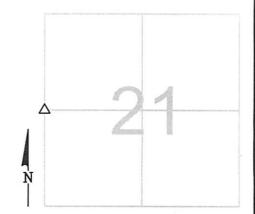

## MONUMENT INFORMATION

MONUMENT TYPE: FD. 7-3/4"x4-3/4"x12" POINTED

**GRANITE STONE** 

ON SURFACE - <u>BELOW</u>: 1.68' <u>LEFT</u> - CL PAV'T - RIGHT: 0.40'

**USED HIGH POINT ON STONE** 

## MISC. INFORMATION

FD. STEEL PLATE WITH A GOLF BALL PER COUNTY RECORDS 0.20' ABOVE STONE. THERE IS AN ANCHOR STONE ON EAST SIDE OF STONE AND A CEDAR HUB WAS FOUND 0.20' WEST OF STONE.



## MARCH 28, 2010

SET 1" SQUARE IRON PIN IN ROUND ODOT MONUMENT BOX OVER STONE

GENZMAN RD., T.R. #96

& SHINER

FD. NAIL

#19

ď

FD. NAIL P