

# OTTAWA COUNTY ENGINEERS OFFICE

REFERENCE NO. 21-7-15-E  
CENTER POST SECTION 21  
CARROLL TWP.  
SHEET 1 OF 1.

ROUTE: T-96 GENZMAN RD.

TOWNSHIP: CARROLL

SECTION: 21

T 7 NR 15 E.

**PERSONNEL:**

M. WITTMAN, P.S.  
J. HAYES - BEC  
K. LENKE

NORTHING:

EASTING:

DATUM:



**DATE / WEATHER / TEMP:**

APRIL 25, 2005  
SUNNY NW  
60° F

MONUMENT INFORMATION


MONUMENT TYPE: FD LIMESTONE W/ NOTCH  
ON SURFACE - BELOW: 1.66'  
LEFT - CL PAV'T - RIGHT: (T-96)  
RECTANGULAR STONE: 1  $\frac{1}{4}$ " E-W x 4  $\frac{3}{4}$ " N-S  
USED NOTCH IN STONE.



MISC. INFORMATION

APRIL 25, 2005

SET 1" SQUARE IRON PIN  
IN MONUMENT BOX OVER  
STONE

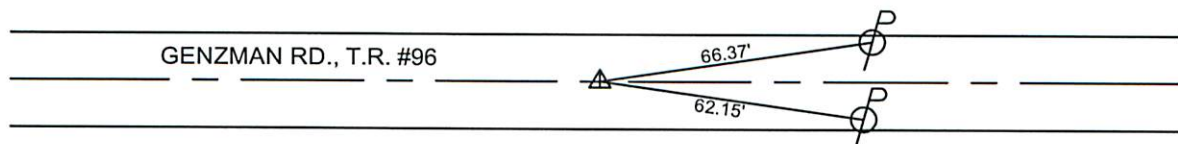

SHORT TIES

SET MAG NAIL N - 3.00'  
SET MAG NAIL E - 3.00'  
SET MAG NAIL S - 3.00'  
SET MAG NAIL W - 3.00'