

# OTTAWA COUNTY ENGINEERS OFFICE

REFERENCE NO. 22-7-15-E  
CENTER POST SECTION 22  
CARROLL TWP.  
SHEET 1 OF 1.

ROUTE: T-96 GENZMAN RD.

TOWNSHIP: CARROLL

SECTION: 22

T 7 N R 15 E.

**PERSONNEL:**

M. WITTMAN, P.S.  
J. ALLEN  
C. MILLER


NORTHING:

EASTING:

DATUM:

**DATE / WEATHER / TEMP:**

JUNE 5, 2009  
SUNNY N  
70° F

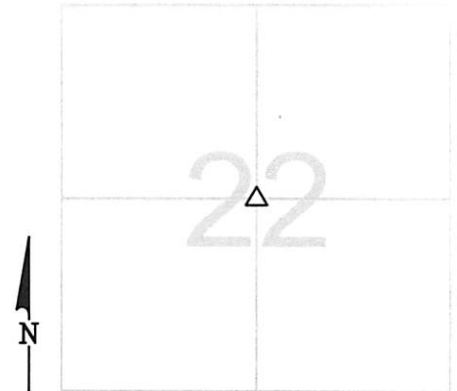

MONUMENT INFORMATION

MONUMENT TYPE: FD HARDHEAD STONE W/ DH  
ON SURFACE - BELOW: 1.55'  
LEFT - CL PAV'T - RIGHT: 0.60'  
FOOTBALL SHAPED STONE: 5" x 10"

USED DRILL HOLE



MISC. INFORMATION

BEC ASSOCIATES DUG STONE AND REPORTED  
TO US ON 1-3-08.

JUNE 5, 2009

SET 1" SQUARE IRON PIN  
IN MONUMENT BOX OVER  
STONE

