## OTTAWA COUNTY ENGINEERS OFFICE

REFERENCE NO. 22-7-15-F EAST QUARTER POST SEC. 22

CARROLL TWP. SHEET 1 OF 1. ROUTE: T-101 LEUTZ RD. @ T-96 GENZMAN RD.

TOWNSHIP: CARROLL

SECTION: 22

PERSONNEL:

M. WITTMAN, P.S. J. ALLEN

T 7 NR 15 E.


NORTHING:

**EASTING:** 

DATE / WEATHER / TEMP:

AUGUST 2, 2012 SUNNY - W 80° F

DATUM:

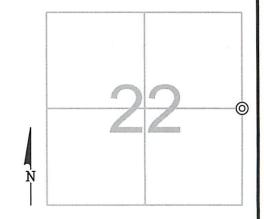

## MONUMENT INFORMATION

MONUMENT TYPE: FD. 3/4" X 12" IRON PIPE

ON SURFACE - BELOW: 1.08' LEFT - CL PAV'T - RIGHT:

IRON PIPE HAD A SQUARE BOLT IN TOP

## MISC. INFORMATION

FD PK NAIL 0.49' BELOW SURFACE TIED W/ X-TIES AND DUG FOR STONE. FOUND IRON PIPE CITED ABOVE UNDER PK NAIL. REMOVED PIPE DUG 6" INTO CLAY AND PRODDED ANOTHER 2' DOWN, DID NOT FIND STONE. SET 1" SQUARE IRON PIN IN MONUMENT BOX IN PLACE OF IRON PIPE.



## AUGUST 2, 2012

SET 1" SQUARE IRON PIN IN MONUMENT BOX

SET MAG NAIL

GENZMAN RD., T.R. #96

#101 ď

RD.

FD PK NAIL