

# OTTAWA COUNTY ENGINEERS OFFICE

REFERENCE NO. 22-7-15-G  
 SW CORNER POST SEC. 22  
 CARROLL TWP.  
 SHEET 1 OF 1.

ROUTE: T-102 BEHLMAN RD.

TOWNSHIP: CARROLL


SECTION: 22

T 7 NR 15 E.

NORTHING:

EASTING:

DATUM:

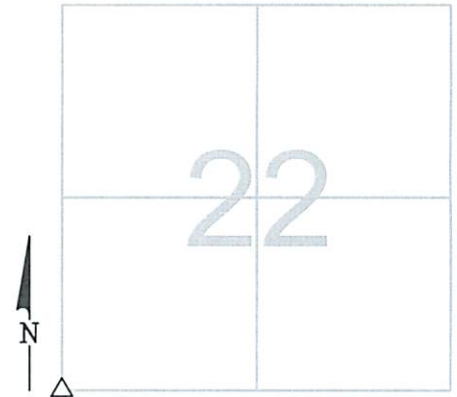

PERSONNEL:  
 M. WITTMAN, P.S.  
 J. ALLEN

DATE / WEATHER / TEMP:  
 JULY 2, 2015  
 SUNNY - N / NE  
 74° F

### MONUMENT INFORMATION

MONUMENT TYPE: FD HARDHEAD STONE  
 ON SURFACE - BELOW: 1.56'  
LEFT - CL PAV'T - RIGHT: 2.60'  
 7"x9" RECTANGULAR FLAT HARDHEAD STONE  
 USED CENTER OF STONE



### MISC. INFORMATION

FD PK NAIL ON SURFACE, TIED W/ X-TIES AND DUG FOR STONE. PK NAIL WAS 0.24' WEST AND 0.18' S OF CENTER OF STONE.

JULY 2, 2015

SET 1" SQUARE IRON PIN  
 IN MONUMENT BOX OVER  
 STONE

