

OTTAWA COUNTY ENGINEERS OFFICE

REFERENCE NO. 23-7-15-D
WEST QUARTER POST SEC. 23
CARROLL TWP.
SHEET 1 OF 1.

ROUTE: T-101 LEUTZ RD.
@ T-96 GENZMAN RD.

TOWNSHIP: CARROLL

SECTION: 23

T 7 NR 15 E.


NORTHING:

EASTING:

DATUM:

PERSONNEL:
M. WITTMAN, P.S.
J. ALLEN

DATE / WEATHER / TEMP:
AUGUST 2, 2012
SUNNY - W
80° F

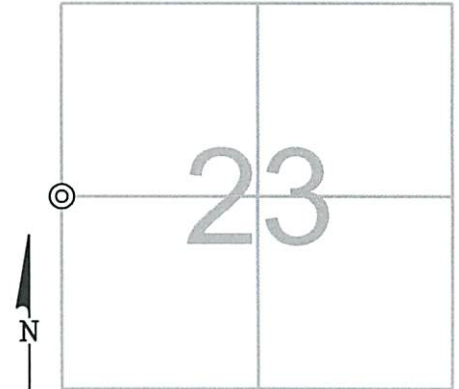

MONUMENT INFORMATION

MONUMENT TYPE: FD. 3/4" X 12" IRON PIPE
ON SURFACE - BELOW: 1.08'
LEFT - CL PAV'T - RIGHT:

IRON PIPE HAD A SQUARE BOLT IN TOP



MISC. INFORMATION

FD PK NAIL 0.49' BELOW SURFACE TIED W/ X-TIES
AND DUG FOR STONE. FOUND IRON PIPE CITED
ABOVE UNDER PK NAIL. REMOVED PIPE DUG 6"
INTO CLAY AND PRODDED ANOTHER 2' DOWN, DID
NOT FIND STONE. SET 1" SQUARE IRON PIN IN
MONUMENT BOX IN PLACE OF IRON PIPE.

AUGUST 2, 2012

SET 1" SQUARE IRON PIN
IN MONUMENT BOX

