

OTTAWA COUNTY ENGINEERS OFFICE

REFERENCE NO. 23-7-15-E
CENTER POST SEC. 23
CARROLL TWP.
SHEET 1 OF 1.

ROUTE: T-96 GENZMAN RD.

TOWNSHIP: CARROLL

SECTION: 23

T 7 NR 15 E.

PERSONNEL:
M. WITTMAN, P.S.
J. ALLEN


NORTHING:

EASTING:

DATUM:

DATE / WEATHER / TEMP:

JULY 31, 2012
SUNNY - SW
86° F

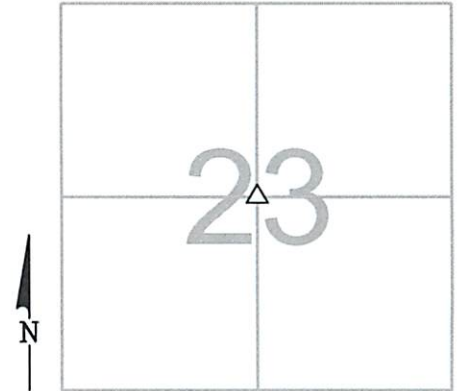

MONUMENT INFORMATION

MONUMENT TYPE: FD 4" X 5" HARDHEAD STONE
ON SURFACE - BELOW: 1.58'
LEFT - CL PAV'T - RIGHT: 0.60'

ROUND STONE

USED CENTER OF STONE



MISC. INFORMATION

DID NOT FIND PK NAIL PER RECORD SURVEYS.
THERE WERE 2'-0" X-TIES ON SURFACE. CENTER OF
STONE CLOSELY MATCHED X-TIES.

JULY 31, 2012

SET 1" SQUARE IRON PIN
IN MONUMENT BOX OVER
STONE

