

# OTTAWA COUNTY ENGINEERS OFFICE

REFERENCE NO. 23-7-15-H  
SOUTH QUARTER POST SEC. 23  
CARROLL TWP.  
SHEET 1 OF 1.

PERSONNEL:  
M. WITTMAN, P.S.  
J. ALLEN

DATE / WEATHER / TEMP:  
MAY 9, 2016  
OVERCAST - E  
58° F

ROUTE: T-15 CAMP PERRY WESTERN RD.

TOWNSHIP: CARROLL


SECTION: 23

T 7 NR 15 E.

NORTHING:

EASTING:

DATUM:

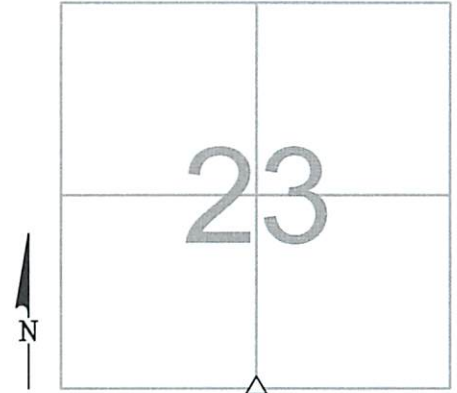

## MONUMENT INFORMATION

MONUMENT TYPE: FD. 7" x 9" HARDHEAD STONE  
ON SURFACE - BELOW: 1.71'  
LEFT - CL PAV'T - RIGHT: 0.30'

STONE HAS A HIGH RIDGE POINT IN NORTHEAST  
CORNER, USED CENTER OF HIGH RIDGE OF STONE.



## MISC. INFORMATION

FD RR SPIKE 0.49' BELOW SURFACE, TIED W/ X-TIES  
AND DUG FOR STONE. FD RR SPIKE WAS 0.05'  
NORTH AND 0.06' EAST OF POINT USED ON STONE.

MAY 9, 2016

SET 1" SQUARE IRON PIN  
IN MONUMENT BOX OVER  
STONE

