

OTTAWA COUNTY ENGINEERS OFFICE

REFERENCE NO. 24-7-15-A
 NW CORNER POST SEC. 24
 CARROLL TWP.
 SHEET 1 OF 1.

ROUTE: C-104 TOUSSAINT SOUTH RD.
 @ T-95 FICK RD.

TOWNSHIP: CARROLL


SECTION: 24

T 7 NR 15 E.

NORTHING:

EASTING:

DATUM:

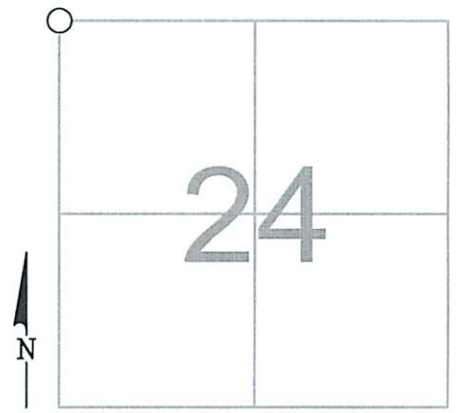


PERSONNEL:
 M. WITTMAN, P.S.
 J. ALLEN
 V. SZABO

DATE / WEATHER / TEMP:
 MAY 10, 2017
 SUNNY - E
 61° F

MONUMENT INFORMATION

MONUMENT TYPE: FD. 5/8" Ø IRON PIN
 ON SURFACE - BELOW: 0.73'
 LEFT - CL PAV'T - RIGHT: 0.65' TOUSSAINT SOUTH ROAD
 LEFT - CL PAV'T - RIGHT: 0.75' GENZMAN ROAD

 IRON PIN OF RECORD IN STONE BOOK.

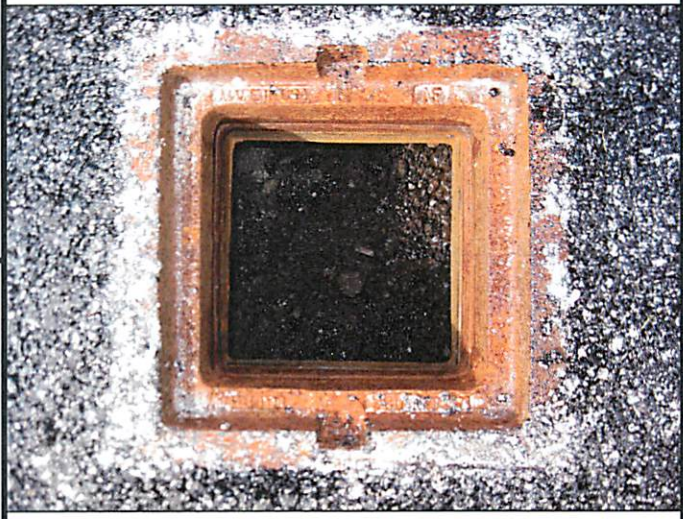

MISC. INFORMATION

FD. MAG SPIKE ON SURFACE W/ 3'-0" PK NAIL
 TIES N,S,E,W. TIED W/ X-TIES AND DUG FOR PIN
 OF RECORD.
 MAG SPIKE WAS ONLINE EAST AND WEST AND
 0.02' SOUTH OF IRON PIN FOUND.

MAY 10, 2017

SET MONUMENT BOX OVER
 5/8" Ø IRON PIN FOUND

