

OTTAWA COUNTY ENGINEERS OFFICE

REFERENCE NO. 24-7-15-D
WEST QUARTER POST SEC. 24
CARROLL TWP.
SHEET 1 OF 1.

ROUTE: C-104 TOUSSAINT SOUTH RD.
@ T-96 GENZMAN RD.

TOWNSHIP: CARROLL

SECTION: 24

T 7 NR 15 E.


NORTHING:

EASTING:

DATUM:

PERSONNEL:
M. WITTMAN, P.S.
J. ALLEN
V. SZABO


DATE / WEATHER / TEMP:
MAY 10, 2017
SUNNY - E
61° F

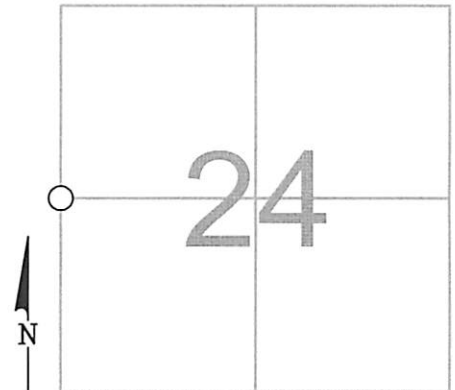

MONUMENT INFORMATION

MONUMENT TYPE: FD. 1" Ø IRON PIN
ON SURFACE - BELOW: 0.59'
LEFT - CL PAV'T - RIGHT: TOUSSAINT SOUTH ROAD
LEFT - CL PAV'T - RIGHT: 1.90' GENZMAN ROAD

IRON PIN OF RECORD IN STONE BOOK.

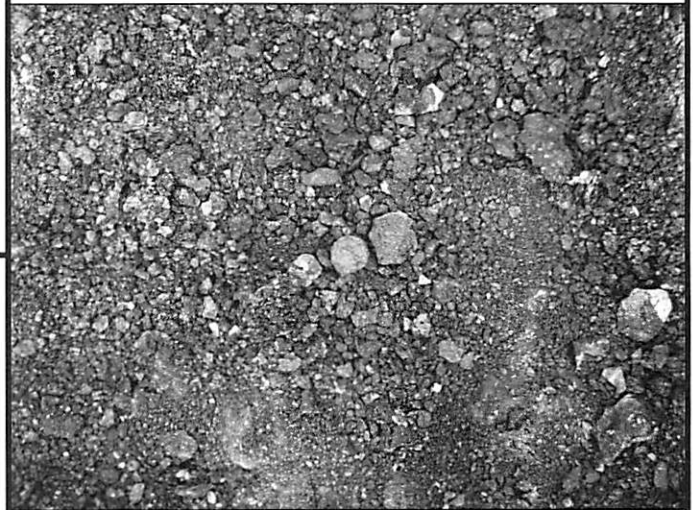

MISC. INFORMATION

FD. RR SPIKE 0.41' BELOW SURFACE, TIED W/
X-TIES AND DUG FOR PIN OF RECORD.
RR SPIKE WAS 0.05' SOUTH AND 0.01' EAST OF
IRON PIN FOUND.

MAY 10, 2017

SET MONUMENT BOX OVER
1" Ø IRON PIN FOUND

