

OTTAWA COUNTY ENGINEERS OFFICE

REFERENCE NO. 24-7-15-F
EAST QUARTER POST SEC. 24
CARROLL TWP.
SHEET 1 OF 1.

ROUTE: C-26 CARROLL - ERIE RD.

TOWNSHIP: CARROLL

SECTION: 24


T 7 NR 15 E.

PERSONNEL:
M. WITTMAN, P.S.
J. ALLEN

NORTHING:

EASTING:

DATUM:

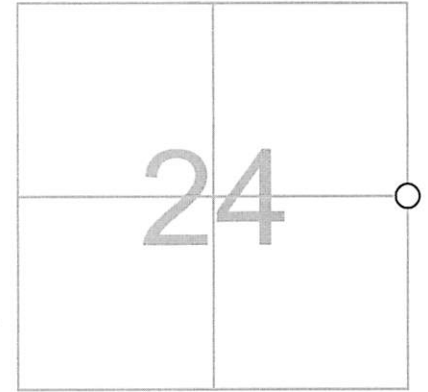

DATE / WEATHER / TEMP:
JUNE 9, 2014
PTLY CLOUDY
72° F

MONUMENT INFORMATION

MONUMENT TYPE: FD 3/4" Ø IRON PIN
ON SURFACE - BELOW: 0.61'
LEFT - CL PAV'T - RIGHT: 6.20'



MISC. INFORMATION

FD PK NAIL AND SHINER ON SURFACE, TIED W/
X-TIES AND DUG FOR IRON PIN IN PIPE OF RECORD.

