

OTTAWA COUNTY ENGINEERS OFFICE

REFERENCE NO. 25-7-15-A
 NW CORNER POST SEC. 25
 CARROLL TWP.
 SHEET 1 OF 1.

PERSONNEL:
 M. WITTMAN, P.S.
 J. ALLEN

DATE / WEATHER / TEMP:
 MAY 9, 2016
 OVERCAST
 54° F

ROUTE: T-15 CAMP PERRY WESTERN RD.
 @ C-104 TOUSSAINT SOUTH RD.

TOWNSHIP: CARROLL


SECTION: 25

T 7 NR 15 E.

NORTHING:

EASTING:

DATUM:

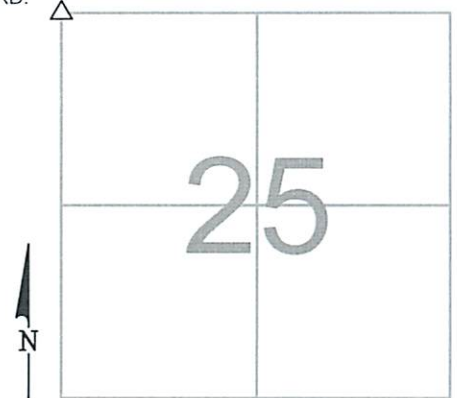

MONUMENT INFORMATION

MONUMENT TYPE: FD 8" x 4" SANDSTONE
 ON SURFACE - BELOW: 1.82'
 LEFT - CL PAV'T - RIGHT: 1.30' (TOUSSAINT SOUTH)
 LEFT - CL PAV'T - RIGHT: 2.00' (CAMP PERRY WESTERN)

 FD SANDSTONE W/ DRILL HOLE - USED DRILL HOLE



MISC. INFORMATION

FD 5/8" Ø IRON PIN (IN SPRING) 0.25' BELOW
 SURFACE, TIED W/ X-TIES AND DUG FOR STONE.
 IRON PIN IN SPRING WAS BENT TO BE OVER STONE.
 CENTER OF IRON PIN WAS 0.03' SOUTH AND 0.03'
 WEST OF DRILL HOLE USED ON STONE.

MAY 9, 2016

SET 1" SQUARE IRON PIN
 IN MONUMENT BOX OVER
 STONE

