

# OTTAWA COUNTY ENGINEERS OFFICE

REFERENCE NO. 25-7-15-B  
NORTH QUARTER POST SEC. 25  
CARROLL TWP.  
SHEET 1 OF 1.

ROUTE: C-15 CAMP PERRY WESTERN RD.

TOWNSHIP: CARROLL

SECTION: 25

T 7 N R 15 E.


**PERSONNEL:**

M. WITTMAN, P.S.  
J. ALLEN  
E. KOCH  
C. MILLER

NORTHING:

EASTING:

DATUM:

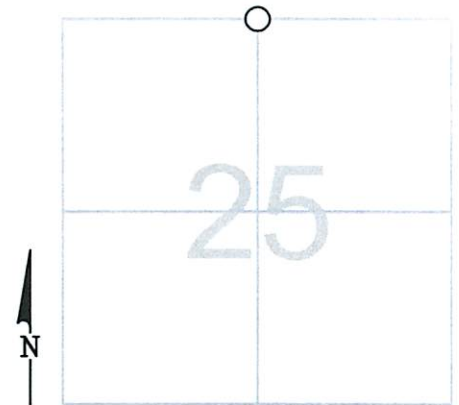

**DATE / WEATHER / TEMP:**

AUGUST 13, 2009  
SUNNY NE  
80° F

MONUMENT INFORMATION

MONUMENT TYPE: FD IRON PIN IN MON BOX  
ON SURFACE - BELOW: 0.63'  
LEFT - CL PAV'T - RIGHT:



MISC. INFORMATION

FD 1" Ø IRON PIN IN ROUND LID MONUMENT BOX.  
BOX WAS FULL OF LIQUID ASPHALT AND DIFFICULT  
TO CLEAN OUT TO EXPOSE PIN. TIED PIN W/ CROSS  
TIES AND REMOVED MON. BOX. IRON PIN WAS  
INADVERTANTLY PULLED DURING BOX REMOVAL.  
RESET 1" SQ. IRON PIN USING CROSS TIES.

AUGUST 8, 2009

RESET 1" SQUARE IRON PIN  
IN MONUMENT BOX

CAMP PERRY WESTERN RD., C.R. #15

