

# OTTAWA COUNTY ENGINEERS OFFICE

REFERENCE NO. 25-7-15-D  
WEST QUARTER POST SEC. 25  
CARROLL TWP.  
SHEET 1 OF 1.

ROUTE: C-104 TOUSSANT SOUTH RD.  
@ T-97 BIER RD.

TOWNSHIP: CARROLL

SECTION: 25

T 7 NR 15 E.


NORTHING:

EASTING:

DATUM:

PERSONNEL:  
M. WITTMAN, P.S.  
J. ALLEN

DATE / WEATHER / TEMP:  
JUNE 26, 2012  
SUNNY - NE  
77° F

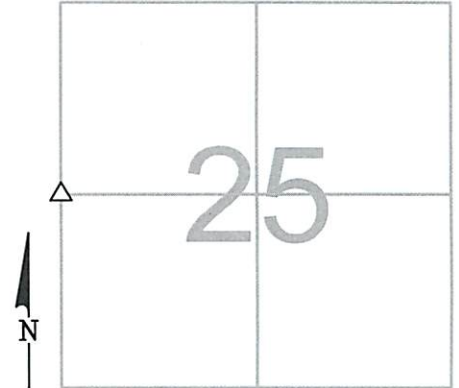

## MONUMENT INFORMATION

MONUMENT TYPE: FD FLAT HARDHEAD STONE W/DH  
ON SURFACE - BELOW: 2.47'  
LEFT - CL PAV'T - RIGHT: 2.40'

STONE IS 8-1/2" X 14" X 9-1/2"

USED DRILL HOLE



## MISC. INFORMATION

FD PK NAIL 0.21' BELOW SURFACE. TIED W/ X-TIES  
AND DUG FOR STONE. PK NAIL WAS 0.03' S AND  
0.03' E OF DRILL HOLE IN STONE.

JUNE 26, 2012

SET 1" SQUARE IRON PIN  
IN MONUMENT BOX OVER  
STONE

