

OTTAWA COUNTY ENGINEERS OFFICE

REFERENCE NO. 25-7-15-H
SOUTH QUARTER POST SEC. 25
CARROLL TWP.
SHEET 1 OF 1.

ROUTE: C-98 SALEM-CARROLL RD.
@ T-105 BROKATE RD.

TOWNSHIP: CARROLL

SECTION: 25

T 7 NR 15 E.


NORTHING:

EASTING:

DATUM:

PERSONNEL:
M. WITTMAN, P.S.
J. ALLEN
C. MILLER

DATE / WEATHER / TEMP:
NOVEMBER 9, 2012
SUNNY
38° F

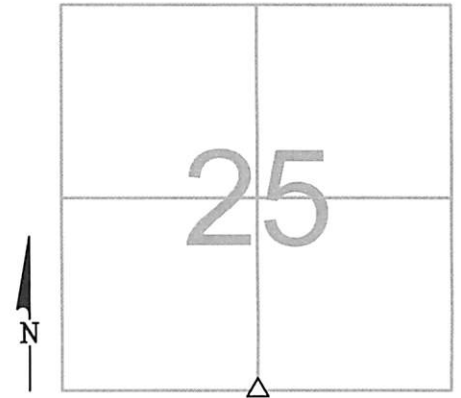

MONUMENT INFORMATION

MONUMENT TYPE: FD. LIMESTONE W/ DH
ON SURFACE - BELOW: 2.00'
LEFT - CL PAV'T - RIGHT:

IRREGULAR SHAPED STONE 3"x5"x10"

USED DRILL HOLE



MISC. INFORMATION

FD. RAILROAD SPIKE 0.54' BELOW SURFACE, TIED
WITH X-TIES AND DUG FOR STONE. RAILROAD
SPIKE HAD A SLIGHT SW LEAN AND WAS 0.04' W
AND 0.02' S OF DRILL HOLE IN STONE.

NOVEMBER 9, 2012

SET 1" SQUARE IRON PIN
IN MONUMENT BOX OVER
STONE

