

OTTAWA COUNTY ENGINEERS OFFICE

REFERENCE NO. 26-7-15-B
 NORTH QUARTER POST SEC. 26
 CARROLL TWP.
SHEET 1 OF 1.

ROUTE: T-15 CAMP PERRY WESTERN RD.

TOWNSHIP: CARROLL


SECTION: 26

T 7 **NR** 15 **E.**

NORTHING:

EASTING:

DATUM:

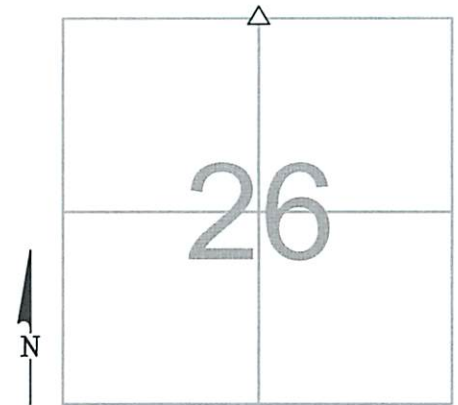

PERSONNEL:
 M. WITTMAN, P.S.
 J. ALLEN

DATE / WEATHER / TEMP:
 MAY 9, 2016
 OVERCAST - E
 58° F

MONUMENT INFORMATION

MONUMENT TYPE: FD. 7" x 9" HARDHEAD STONE
 ON SURFACE - BELOW: 1.71'
LEFT - CL PAV'T - RIGHT: 0.30'

 STONE HAS A HIGH RIDGE POINT IN NORTHEAST
 CORNER, USED CENTER OF HIGH RIDGE OF STONE.



MISC. INFORMATION

FD RR SPIKE 0.49' BELOW SURFACE, TIED W/ X-TIES
 AND DUG FOR STONE. FD RR SPIKE WAS 0.05'
 NORTH AND 0.06' EAST OF POINT USED ON STONE.

MAY 9, 2016

SET 1" SQUARE IRON PIN
 IN MONUMENT BOX OVER
 STONE

