

# OTTAWA COUNTY ENGINEERS OFFICE

REFERENCE NO. 26-7-15-D  
WEST QUARTER POST SEC. 26  
CARROLL TWP.  
SHEET 1 OF 1.

ROUTE: T-97 BIER RD.  
@ T-101 LEUTZ RD.

TOWNSHIP: CARROLL

SECTION: 26

T 7 NR 15 E.


NORTHING:

EASTING:

DATUM:

PERSONNEL:  
M. WITTMAN, P.S.  
J. ALLEN  
V. SZABO

DATE / WEATHER / TEMP:  
MAY 10, 2017  
SUNNY - E  
54° F

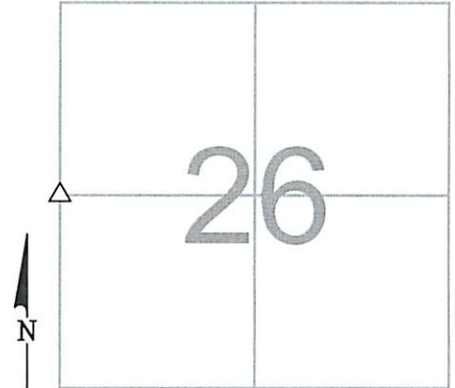

## MONUMENT INFORMATION

MONUMENT TYPE: FD. 6" X 6" LIMESTONE  
ON SURFACE - BELOW: 1.66'  
LEFT - CL PAV'T - RIGHT: 1.50' BIER ROAD  
LEFT - CL PAV'T - RIGHT: 2.40' LEUTZ ROAD

USED FD. DRILL HOLE IN STONE.



## MISC. INFORMATION

FD. PK NAIL ON SURFACE W/ 2'-0" PK NAIL TIES  
N,S,&E, TIED W/ X-TIES AND DUG FOR STONE.  
SURFACE PK NAIL WAS 0.01' NORTH AND 0.01'  
EAST OF DRILL HOLE IN STONE.

MAY 10, 2017

SET 1" SQUARE IRON PIN  
IN MONUMENT BOX OVER  
STONE

