

OTTAWA COUNTY ENGINEERS OFFICE

REFERENCE NO. 26-7-15-F
EAST QUARTER POST SEC. 26
CARROLL TWP.
SHEET 1 OF 1.

ROUTE: C-104 TOUSSANT SOUTH RD.
@ T-97 BIER RD.

TOWNSHIP: CARROLL

SECTION: 26

T 7 NR 15 E.


NORTHING:

EASTING:

DATUM:

PERSONNEL:
M. WITTMAN, P.S.
J. ALLEN

DATE / WEATHER / TEMP:
JUNE 26, 2012
SUNNY - NE
77° F

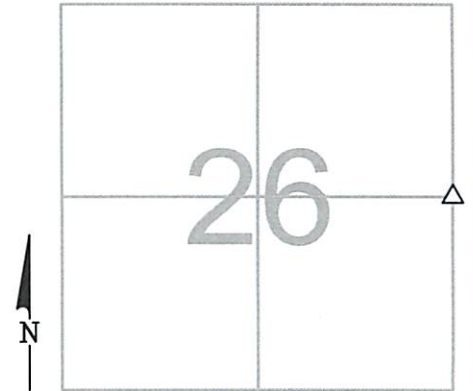

MONUMENT INFORMATION

MONUMENT TYPE: FD FLAT HARDHEAD STONE W/DH
ON SURFACE - BELOW: 2.47'
LEFT - CL PAV'T - RIGHT: 2.40'

STONE IS 8-1/2" X 14" X 9-1/2"

USED DRILL HOLE



MISC. INFORMATION

FD PK NAIL 0.21' BELOW SURFACE. TIED W/ X-TIES
AND DUG FOR STONE. PK NAIL WAS 0.03' S AND
0.03' E OF DRILL HOLE IN STONE.

JUNE 26, 2012

SET 1" SQUARE IRON PIN
IN MONUMENT BOX OVER
STONE

