

# OTTAWA COUNTY ENGINEERS OFFICE

REFERENCE NO. 27-7-15-D  
WEST QUARTER POST SEC. 27  
CARROLL TWP.  
SHEET 1 OF 1.

ROUTE: T-102 BEHLMAN RD.  
@ T-97 BIER RD.

TOWNSHIP: CARROLL

SECTION: 27

T 7 NR 15 E.


NORTHING:

EASTING:

DATUM:

PERSONNEL:  
M. WITTMAN, P.S.  
J. ALLEN

DATE / WEATHER / TEMP:  
JULY 1, 2015  
OVERCAST - W  
67° F

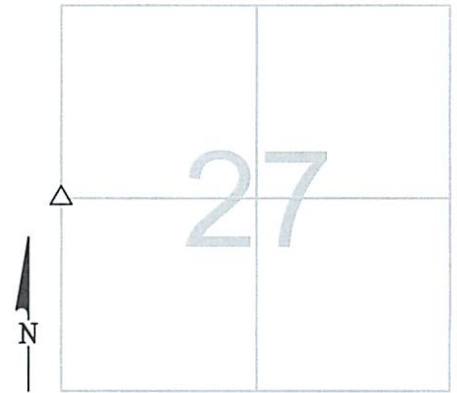

## MONUMENT INFORMATION

MONUMENT TYPE: 10 1/2" x 10 1/2" LIMESTONE  
ON SURFACE - BELOW: 1.97'  
LEFT - CL PAV'T - RIGHT: 2.35' (BEHLMAN RD.)  
LEFT - CL PAV'T - RIGHT: (BIER RD.)

RESEMBLED SHAPE OF OHIO

USED CENTER OF STONE



## MISC. INFORMATION

FD PK NAIL ON SURFACE, TIED W/ X-TIES AND  
DUG FOR STONE. STONE IS CRACKED AND  
BROKEN IN VARIOUS PLACES. SURFACE PK NAIL  
WAS ONLINE NORTH AND SOUTH AND 0.6' EAST  
OF CENTER OF STONE.

JULY 1, 2015

SET 1" SQUARE IRON PIN  
IN MONUMENT BOX OVER  
STONE

