

OTTAWA COUNTY ENGINEERS OFFICE

REFERENCE NO. 27-7-15-E
 CENTER POST SEC. 27
 CARROLL TWP.
 SHEET 1 OF 1.

ROUTE: T-97 BIER RD.

TOWNSHIP: CARROLL

SECTION: 27

T 7 NR 15 E.


PERSONNEL:
 M. WITTMAN, P.S.
 J. ALLEN

NORTHING:

EASTING:

DATE / WEATHER / TEMP:
 MAY 9, 2017
 SUNNY - E
 58° F

DATUM:

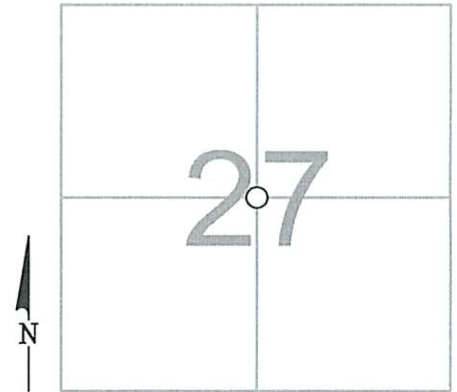

MONUMENT INFORMATION

MONUMENT TYPE: FD. RAILROAD SPIKE
ON SURFACE - BELOW:
 LEFT - CL PAV'T - RIGHT: 2.00'

NO RECORD OF STONE. STAKE PER C.E. DEWITT
 SURVEY DATED 9-1896.



MISC. INFORMATION

FD. RAILROAD SPIKE ON SURFACE, TIED W/ X-TIES
 AND DUG FOR ANY KIND OF MONUMENT. DUG
 DOWN 1.50' INTO CLAY AND PRODDED ENTIRE
 HOLE IN A 4" GRID ANOTHER 3' DOWN. DID NOT
 FIND ANY STONE OR EVIDENCE OF A STAKE. USED
 RAILROAD SPIKE LOCATION.

MAY 9, 2017

SET 1" SQUARE IRON PIN
 IN MONUMENT BOX IN PLACE
 OF RAILROAD SPIKE

