

OTTAWA COUNTY ENGINEERS OFFICE

REFERENCE NO. 28-7-15-C
 NE CORNER POST SEC. 28
 CARROLL TWP.
 SHEET 1 OF 1.

ROUTE: T-102 BEHLMAN RD.

TOWNSHIP: CARROLL

SECTION: 28

T 7 NR 15 E.


NORTHING:

EASTING:

DATUM:

PERSONNEL:
 M. WITTMAN, P.S.
 J. ALLEN

DATE / WEATHER / TEMP:
 JULY 2, 2015
 SUNNY - N / NE
 74° F

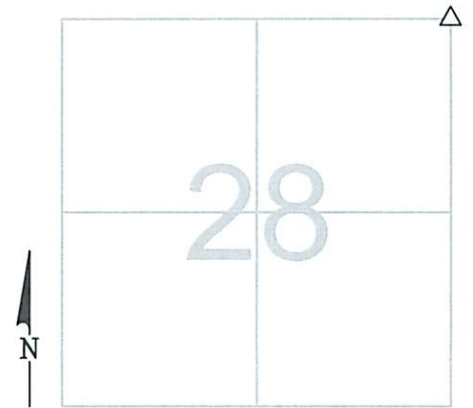

MONUMENT INFORMATION

MONUMENT TYPE: FD HARDHEAD STONE
 ON SURFACE - BELOW: 1.56'
LEFT - CL PAV'T - RIGHT: 2.60'
 7"x9" RECTANGULAR FLAT HARDHEAD STONE
 USED CENTER OF STONE



MISC. INFORMATION

FD PK NAIL ON SURFACE, TIED W/ X-TIES AND DUG FOR STONE. PK NAIL WAS 0.24' WEST AND 0.18' S OF CENTER OF STONE.

JULY 2, 2015

SET 1" SQUARE IRON PIN
 IN MONUMENT BOX OVER
 STONE

