

OTTAWA COUNTY ENGINEERS OFFICE

REFERENCE NO. 28-7-15-D
 WEST QUARTER POST SEC. 28
 CARROLL TWP.
SHEET 1 OF 1.

ROUTE: STATE ROUTE #19
 @ T-97 BIER RD.

TOWNSHIP: CARROLL

SECTION: 28

T 7 **NR** 15 **E.**


PERSONNEL:
 M. WITTMAN, P.S.
 S. HUSS - ODOT
 M. CANTERBURY - ODOT

NORTHING:

EASTING:

DATE / WEATHER / TEMP:
 MARCH 30, 2010
 SUNNY - S
 66° F

DATUM:

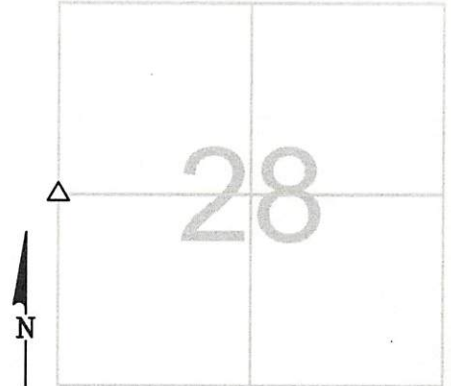

MONUMENT INFORMATION

MONUMENT TYPE: FD. 8-1/2"x6" ROUND HARDHEAD
 STONE
 ON SURFACE - BELOW: 1.51'
LEFT - CL PAV'T - RIGHT: 3.53'

 USED CENTER OF STONE



MISC. INFORMATION

FD. ODOT NAIL AND SHINER ON SURFACE WITH 3'-0"
 X-TIES. DUG FOR STONE. FD. 1" SQ WOODEN HUB
 0.96' BELOW SURFACE WITH BROKEN CLAY TILE ON
 ALL SIDES IN PEA GRAVEL. HUB WAS 0.16' E AND
 0.08' S OF NAIL AND SHINER. KEPT DIGGING AND
 FOUND STONE.

MARCH 30, 2010

SET 1" SQUARE IRON PIN
 IN ROUND ODOT MONUMENT
 BOX OVER STONE

