

OTTAWA COUNTY ENGINEERS OFFICE

REFERENCE NO. 28-7-15-F
EAST QUARTER POST SEC. 28
CARROLL TWP.
SHEET 1 OF 1.

ROUTE: T-102 BEHLMAN RD.
@ T-97 BIER RD.

TOWNSHIP: CARROLL

SECTION: 28

T 7 NR 15 E.


NORTHING:

EASTING:

DATUM:

PERSONNEL:
M. WITTMAN, P.S.
J. ALLEN

DATE / WEATHER / TEMP:
JULY 1, 2015
OVERCAST - W
67° F

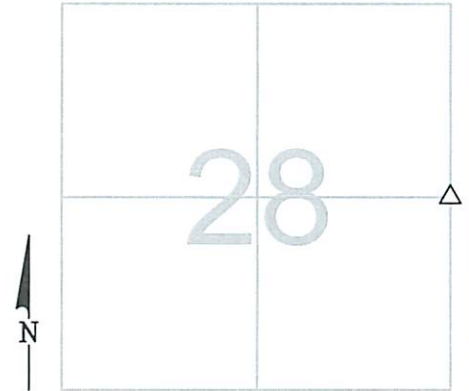

MONUMENT INFORMATION

MONUMENT TYPE: 10 1/2" x 10 1/2" LIMESTONE
ON SURFACE - BELOW: 1.97'
LEFT - CL PAV'T - RIGHT: 2.35' (BEHLMAN RD.)
LEFT - CL PAV'T - RIGHT: (BIER RD.)

RESEMBLED SHAPE OF OHIO

USED CENTER OF STONE



MISC. INFORMATION

FD PK NAIL ON SURFACE, TIED W/ X-TIES AND
DUG FOR STONE. STONE IS CRACKED AND
BROKEN IN VARIOUS PLACES. SURFACE PK NAIL
WAS ONLINE NORTH AND SOUTH AND 0.6' EAST
OF CENTER OF STONE.

JULY 1, 2015

SET 1" SQUARE IRON PIN
IN MONUMENT BOX OVER
STONE

