

OTTAWA COUNTY ENGINEERS OFFICE

REFERENCE NO. 28-7-15-H
 SOUTH QUARTER POST SEC. 28
 CARROLL TWP.
 SHEET 1 OF 1.

ROUTE: C-98 SALEM-CARROLL RD.

TOWNSHIP: CARROLL

SECTION: 28

T 7 NR 15 E.

PERSONNEL:

M. WITTMAN, P.S.
 J. ALLEN
 E. KOCH
 C. MILLER


NORTHING:

EASTING:

DATE / WEATHER / TEMP:

AUGUST 11, 2009
 OVERCAST HUMID
 74° F

DATUM:

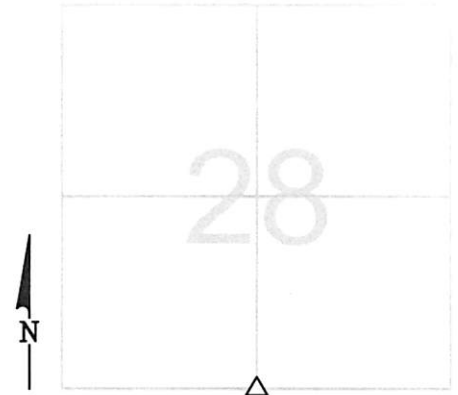

MONUMENT INFORMATION

MONUMENT TYPE: FD POINTED HARDHEAD STONE
 ON SURFACE - BELOW: 1.32'
 LEFT - CL PAV'T - RIGHT: 2.00'
 TRIANGULAR STONE: 9 3/4" x 4 1/2"

USED CENTER OF HIGH RIDGE.



MISC. INFORMATION

FD 1" HITCH PIN 0.44' BELOW SURFACE. TIED W/ CROSS TIES AND DUG FOR STONE. FD 1" Ø IRON PIN 1.16' BELOW SURFACE. IRON PIN ON SOUTH SIDE OF STONE MARKING C/L OF HIGH RIDGE OF STONE. PIN HAD SLANT TO NORTH. IT IS BELIEVED THAT PIN WAS ORIGINALLY SLANTED NORTH OVER THE CENTER OF STONE AND HAS SINCE BEEN DRIVEN DOWN. HITCH PIN WAS OVER IRON PIN AND 0.22' SOUTH OF CENTER OF STONE.

AUGUST 11, 2009

SET 1" SQUARE IRON PIN
 IN MONUMENT BOX OVER
 STONE

