

OTTAWA COUNTY ENGINEERS OFFICE

REFERENCE NO. 28-7-15-1
SE CORNER POST SECTION 28
CARROLL TWP.
SHEET 1 OF 1.

ROUTE: C-98 SSALEM-CARROLL RD.

TOWNSHIP: CARROLL

SECTION: 28

T 7 NR 15 E.

PERSONNEL:

M. WITTMAN, P.S.
J. ALLEN
C. MILLER


NORTHING:

EASTING:

DATE / WEATHER / TEMP:

AUGUST 10, 2009
SUNNY HUMID SW
90° F

DATUM:

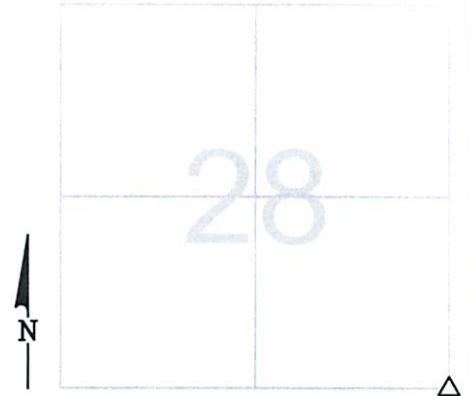

MONUMENT INFORMATION

MONUMENT TYPE: FD POINTED LIMESTONE
ON SURFACE - BELOW: 2.04'
LEFT - CL PAV'T - RIGHT: 2.15'
RECTANGULAR STONE: 2" x 4" TOP

USED HIGHPOINT OF STONE.



MISC. INFORMATION

FD PK NAIL ON SURFACE. TIED W/ CROSS TIES AND
DUG FOR STONE. PK NAIL WAS 0.10' SOUTH AND
0.12' WEST OF HIGH POINT OF STONE.

