

# OTTAWA COUNTY ENGINEERS OFFICE

REFERENCE NO. 29-7-15-A  
NW CORNER POST SEC 29  
CARROLL TWP.  
SHEET 1 OF 1.

PERSONNEL:  
M. WITTMAN, P.S.  
J. ALLEN

DATE / WEATHER / TEMP:  
JUNE 21, 2011  
SUNNY  
81° F

ROUTE: T-92 TOUSSAINT PORTAGE RD.

TOWNSHIP: CARROLL


SECTION: 29

T 7 NR 15 E.

NORTHING:

EASTING:

DATUM:

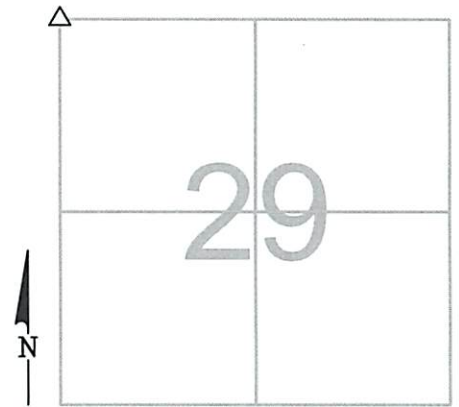

## MONUMENT INFORMATION

MONUMENT TYPE: LIMESTONE W/ DH  
ON SURFACE - BELOW: 1.82'  
LEFT - CL PAV'T - RIGHT: 2.0'  
RECTANGULAR STONE: 6"X7"X14"



## MISC. INFORMATION

FD RR SPK W/ PUNCH MARK ON SURFACE  
FIT TIES PER STONE RECORD  
TIED RR SPK W/ X-TIES & DUG FOR STONE  
RR SPK WAS 0.04' S OF DH ON LINE E&W

JUNE 21, 2011

SET 1" SQUARE IRON PIN  
IN MONUMENT BOX OVER  
STONE

